

STATE ENGINEER
Salem, Oregon

LINN Well Record
13589

STATE WELL NO. 11/3W-11D(1)
COUNTY Linn
APPLICATION NO. GR-41

OWNER: Willard Keen

MAILING
ADDRESS:

LOCATION OF WELL: Owner's No. 1


CITY AND
STATE:

Halsey, Oregon

NW $\frac{1}{4}$ NW $\frac{1}{4}$ Sec. 11 T. 14 N. S. R. 3 E. W., W.M.

Bearing and distance from section or subdivision

corner N. 83° W. 26.5 chs. from SW cor. DLG 38

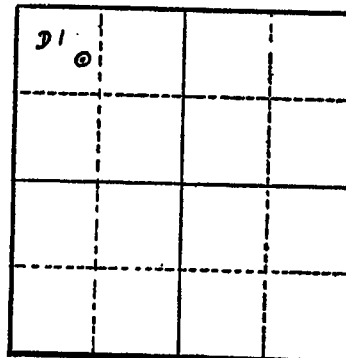

Altitude at well 305 ft. Interpolated

TYPE OF WELL: drilled Date Constructed Sept. 1953

Depth drilled 57 ft. Depth cased 50 ft.

Section 11

CASING RECORD: 5 inch casing set from 0 to 50 ft.

FINISH: Perforations used between 45 and 50 ft.

AQUIFERS: Gravel, from 16 to 30 ft.
Sand, from 50 to 57 ft.

WATER LEVEL: 12 ft. below land surface Sept. 1953

PUMPING EQUIPMENT: Type Coop. deep well H.P. 1 1/2
Capacity 15 G.P.M.

WELL TESTS:

Drawdown 30 ft. after 15 hours G.P.M.

Drawdown ft. after hours G.P.M.

USE OF WATER irrigation 3 acres Temp. °F. 19

SOURCE OF INFORMATION Reg. St. GR-41

DRILLER or DIGGER

ADDITIONAL DATA:

Log X Water Level Measurements Chemical Analysis Aquifer Test

REMARKS:

50
LINN
13589

Application No. GR-41

Driller: Date Drilled September 1953.....

[illegible]