

STATE ENGINEER
Salem, Oregon

LINN Well Record

STATE WELL NO. 14/3W-17A
COUNTY Linn
APPLICATION NO. GR-940

13628

OWNER: Merwin L. & Grace J. Vannice


MAILING ADDRESS: Rt. 1

LOCATION OF WELL: Owner's No. 1

CITY AND STATE: Halsey, Oregon

NE 1/4 NE 1/4 Sec. 17 T. 14 S., R. 3 W., W.M.

Bearing and distance from section or subdivision
corner S. 9° 58' W. 4.72 chs. from NE cor. Sec. 17

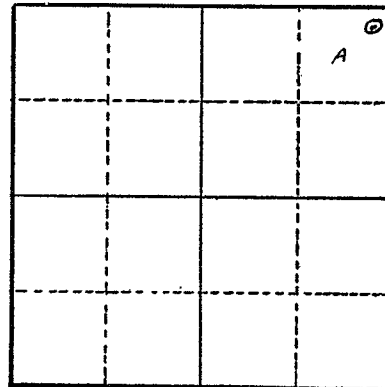

Section 17

Altitude at well 295 ft.

TYPE OF WELL: drilled Date Constructed July 1955

Depth drilled 60 ft. Depth cased 54 ft.

CASING RECORD: 6 in. steel 0 to 54 ft.

FINISH: Slot perforations 25 to 30 ft.
44 to 54 ft.

AQUIFERS:

WATER LEVEL: 10 ft.

PUMPING EQUIPMENT: Type Deep well jet H.P. 1 elec.
Capacity 50 G.P.M.

WELL TESTS:

Drawdown 20 ft. after _____ hours 25 G.P.M.

Drawdown _____ ft. after _____ hours _____ G.P.M.

USE OF WATER irrigated Temp. _____ °F. _____, 19____

SOURCE OF INFORMATION owner

DRILLER or DIGGER Slate Drilling Co.; Tangent, Oregon

ADDITIONAL DATA:

Log _____ Water Level Measurements _____ Chemical Analysis _____ Aquifer Test _____

REMARKS: