

STATE ENGINEER
Salem, Oregon

Well Record
13731

STATE WELL NO. 14/LW-48(1)
COUNTY Linn
APPLICATION NO. GR-240

OWNER: J. S. Nicewood

MAILING

ADDRESS: Rt. 1

LOCATION OF WELL: Owner's No. 1

CITY AND


STATE: Halsey, Oregon

NW 1/4 NE 1/4 Sec. 4 T. 14 S. R. 4 W., W.M.

Bearing and distance from section or subdivision

corner S. 82° E. 29 chs. from NE cor. Henry W. Parks

DLC 41

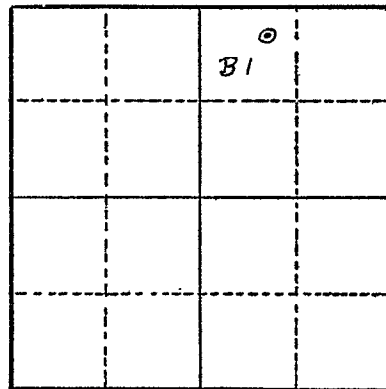

Altitude at well 275 ft. Interpolated

TYPE OF WELL: drilled Date Constructed 5/12/39

Depth drilled 118 ft. Depth cased 110 ft.

Section 4

CASING RECORD: 8 inch steel casing set from 10 to 50 ft.
6 inch steel casing set from 50 to 110 ft.

FINISH: Slit perforations from 40 to 50 ft.
Slit perforations from 90 to 100 ft.

AQUIFERS: unknown

WATER LEVEL: 12 ft. below land surface

PUMPING EQUIPMENT: Type _____ H.P. _____
Capacity _____ G.P.M.

WELL TESTS:
Drawdown 45 ft. after _____ hours pumping 100 G.P.M.
Drawdown _____ ft. after _____ hours _____ G.P.M.

USE OF WATER irrigation 24.5 acres Temp. _____ °F. _____ 19.

SOURCE OF INFORMATION Reg. St. GR-240

DRILLER or DIGGER A. W. Sloper; Rt. 4, Albany, Oregon

ADDITIONAL DATA:

Log _____ Water Level Measurements _____ Chemical Analysis _____ Aquifer Test _____

REMARKS: