

STATE ENGINEER  
Salem, Oregon

**LINN**  
13736

# Well Record

STATE WELL NO. 14/4W-5D(1)  
COUNTY Linn  
APPLICATION NO. GR-896

OWNER: John or Bessie Miller


MAILING  
ADDRESS: \_\_\_\_\_

LOCATION OF WELL: Owner's No. \_\_\_\_\_

CITY AND  
STATE: Halsey, Oregon

NW  $\frac{1}{4}$  NW  $\frac{1}{4}$  Sec. 5 T. 14 N. S., R. 4 E. W., W.M.

Bearing and distance from section or subdivision  
corner S. 42° 50' E. 27.0 chs. from NW cor. Sec. 5

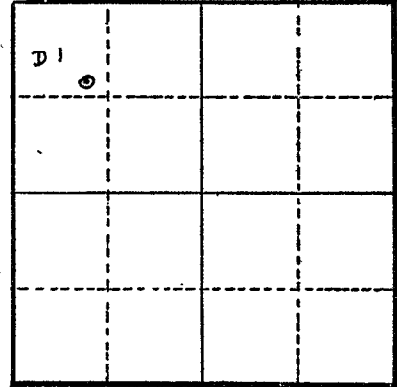

Section 5

Altitude at well 271 ft.

TYPE OF WELL: drilled Date Constructed Dec. 1951

Depth drilled 108 ft. Depth cased 86 ft.

CASING RECORD:  
8 inch steel 0 to 56 ft.  
6 inch steel 56 to 86 ft.

FINISH: Slot perforations 20 to 86 ft.  
Perf.  $\frac{1}{4}$ " x 8" 8 in. apart

AQUIFERS:

WATER LEVEL: 16 ft.

PUMPING EQUIPMENT: Type Fairbanks Morse turbine H.P. 10  
Capacity 250 G.P.M.

WELL TESTS:  
Drawdown 30 ft. after \_\_\_\_\_ hours 300 (estimate) G.P.M.  
Drawdown \_\_\_\_\_ ft. after \_\_\_\_\_ hours \_\_\_\_\_ G.P.M.

USE OF WATER irrigation Temp. \_\_\_\_\_ °F., 19 \_\_\_\_\_

SOURCE OF INFORMATION owner

DRILLER or DIGGER Casey Jones

ADDITIONAL DATA:

Log \_\_\_\_\_ Water Level Measurements \_\_\_\_\_ Chemical Analysis \_\_\_\_\_ Aquifer Test \_\_\_\_\_

REMARKS: