

STATE ENGINEER
Salem, Oregon

Well Record
13743

STATE WELL NO. 14/LW - 6R
COUNTY LANE
APPLICATION NO. GR-2130

OWNER: Marshall W. or Lorene Spivey

MAILING ADDRESS: Route 3 Box 910


LOCATION OF WELL: Owner's No. _____

CITY AND STATE: Junction City, Oregon

SE $\frac{1}{4}$ SE $\frac{1}{4}$ Sec. 6 T. 14 N. S., R. 4 H. W., W.M.

Bearing and distance from section or subdivision

corner 1125' W.

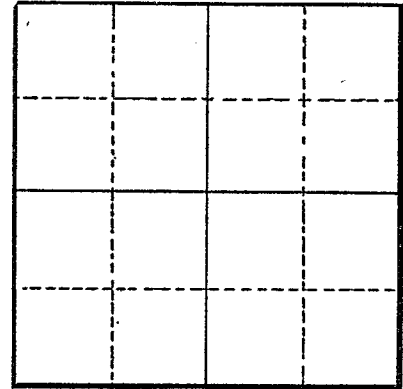

Altitude at well _____

TYPE OF WELL: Driven Date Constructed 1944

Depth drilled 20 Depth cased 20

Section _____

CASING RECORD:

4-Inch

FINISH:

Perforations from 16 to 20

AQUIFERS:

WATER LEVEL:

12-feet

PUMPING EQUIPMENT: Type Cornell Centrifugal H.P. 5
Capacity 105 G.P.M.

WELL TESTS:

Drawdown Unknown ft. after _____ hours Pumping 400 Approx. G.P.M.

Drawdown _____ ft. after _____ hours _____ G.P.M.

USE OF WATER Irrigation Temp. _____ °F., 19 _____

SOURCE OF INFORMATION GR-2045

DRILLER or DIGGER Ralph Phillips (deceased)

ADDITIONAL DATA:

Log _____ Water Level Measurements _____ Chemical Analysis _____ Aquifer Test _____

REMARKS: