

STATE ENGINEER
Salem, Oregon

LINN Well Record
13745

STATE WELL NO. 14/LW-7B(1)
COUNTY Linn
APPLICATION NO. GR-287

OWNER: Joe & Lottie Miller


MAILING
ADDRESS: _____

LOCATION OF WELL: Owner's No. 1

CITY AND
STATE: Halsey, Oregon

NW $\frac{1}{4}$ NE $\frac{1}{4}$ Sec. 7 T. 14 N. S., R. 4 E. W., W.M.

Bearing and distance from section or subdivision
corner S. 70° 30' W. 35.5 chs. from NE cor. Sec. 7

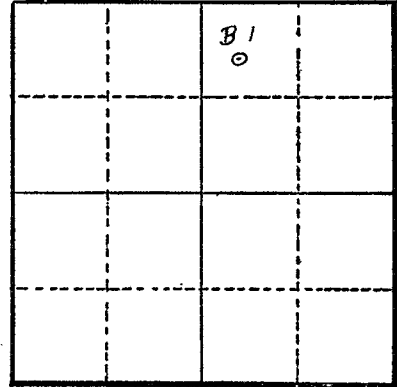

Section 7

Altitude at well 272 ft. Interpolated

TYPE OF WELL: drilled Date Constructed 5/20/51

Depth drilled 70 Depth cased 70

CASING RECORD: 10 inch steel casing set from 0 to 70 ft.

FINISH: Slit perforations set 60 to 70 ft.

AQUIFERS: unknown

WATER LEVEL: 16 ft. below land surface

PUMPING EQUIPMENT: Type Deming deep well turbine H.P. 7½
Capacity 150 G.P.M.

WELL TESTS:
Drawdown 40 ft. after _____ hours pumping 150 G.P.M.
Drawdown _____ ft. after _____ hours _____ G.P.M.

USE OF WATER irrigation 14 acres Temp. _____ °F., 19

SOURCE OF INFORMATION Reg. St. GR-287

DRILLER or DIGGER Mack Slate; Tangent, Oregon

ADDITIONAL DATA:

Log _____ Water Level Measurements _____ Chemical Analysis _____ Aquifer Test _____

REMARKS: