

STATE ENGINEER
Salem, Oregon

LINN
13751

Well Record

STATE WELL NO. 14/LW-8C
COUNTY Linn
APPLICATION NO. GR-3449

OWNER: Elmer J. Kropf

MAILING
ADDRESS: Halsey, Oregon


LOCATION OF WELL: Owner's No. _____

CITY AND
STATE: _____

NE $\frac{1}{4}$ NW $\frac{1}{4}$ Sec. 8 T. 14 N. S., R. 4 E. W., W.M.

Bearing and distance from section or subdivision

corner 1188' S. and 2442' E.

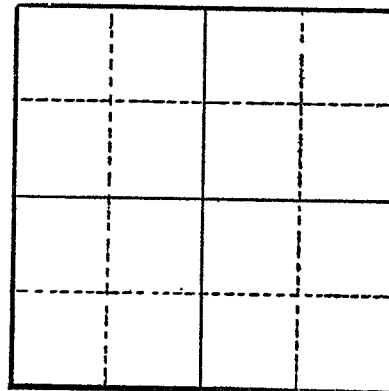

Section _____

Altitude at well _____

TYPE OF WELL: drilled Date Constructed 1950

Depth drilled 40' Depth cased 40'

CASING RECORD:

8"

FINISH:

slot perforations from 30 to 40

AQUIFERS:

WATER LEVEL:

19'

PUMPING EQUIPMENT: Type Pacific Turbine

H.P. 5

Capacity 110 G.P.M.

WELL TESTS:

Drawdown _____ ft. after _____ hours _____ G.P.M.

Drawdown _____ ft. after _____ hours _____ G.P.M.

USE OF WATER Irrigation

Temp. _____ °F. _____, 19

SOURCE OF INFORMATION GR-3190

DRILLER or DIGGER Sloper and Son, Independence, Oregon

ADDITIONAL DATA:

Log _____ Water Level Measurements _____ Chemical Analysis _____ Aquifer Test _____

REMARKS: