

STATE ENGINEER
Salem, Oregon

LINN
13752

Well Record

STATE WELL NO. 14/4W-80
COUNTY Linn
APPLICATION NO. GR-1685

GR-1635

OWNER: Wilbur & Velma F. Evans

MAILING

ADDRESS: Rt. 1

LOCATION OF WELL: Owner's No. #1


CITY AND

STATE: Halsey, Oregon

SW 1/4 SE 1/4 Sec. 8 T. 14 S., R. 4 W., W.M.

Bearing and distance from section or subdivision

corner 264' N. & 2145' W. from SE cor. Sec. 8

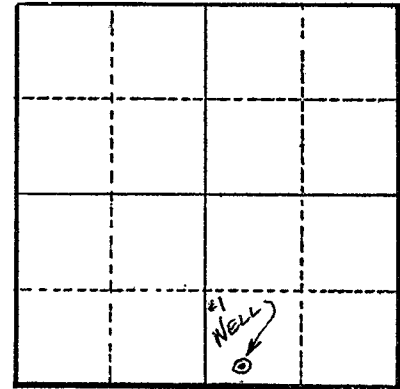

Altitude at well 320'

TYPE OF WELL: Drilled Date Constructed 1948

Depth drilled 54' Depth cased 54'

Section 8

CASING RECORD:

6"

FINISH:

Slot perforations from 24 to 54 ft.

AQUIFERS:

WATER LEVEL:

16'

PUMPING EQUIPMENT: Type Deep Well Turbine H.P. 5
Capacity 175 G.P.M.

WELL TESTS:

Drawdown 2 ft. after 250 hours G.P.M.

Drawdown ft. after hours G.P.M.

USE OF WATER Irrigation Temp. °F., 19

SOURCE OF INFORMATION GR Record

DRILLER or DIGGER Bill Hamilton

ADDITIONAL DATA:

Log N.A. Water Level Measurements Chemical Analysis Aquifer Test

REMARKS:

Irrigation of 12 acres.