

STATE ENGINEER
Salem, Oregon

L I N N
13754 Well Record

STATE WELL NO. 14/4W-9H
COUNTY Linn
APPLICATION NO. GR-3237

OWNER: Reuben R. and Hazel A. Hughes


MAILING ADDRESS: Route 1

LOCATION OF WELL: Owner's No. _____

CITY AND STATE: Halsey, Oregon

SE $\frac{1}{4}$ NE $\frac{1}{4}$ Sec. 9 T. 14 N, R. 4 E, W.M.

Bearing and distance from section or subdivision
corner 1386' S. and 1254' W. of the NE Corner
of Section 9

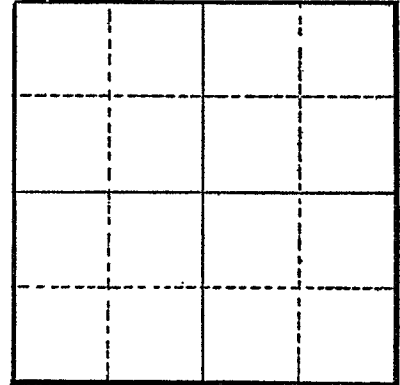

Section _____

Altitude at well _____

TYPE OF WELL: drilled Date Constructed 1951

Depth drilled 98 Depth cased 73

CASING RECORD:

10 inch

FINISH:

Slot perforations from 67 to 73

AQUIFERS:

WATER LEVEL:

PUMPING EQUIPMENT: Type Fairbanks Morse Centrifugal H.P. 7
Capacity _____ G.P.M.

WELL TESTS:

Drawdown _____ ft. after _____ hours _____ G.P.M.

Drawdown _____ ft. after _____ hours _____ G.P.M.

USE OF WATER Irrigation Temp. _____ °F. _____, 19____

SOURCE OF INFORMATION GR-3014

DRILLER or DIGGER Bill Hamilton Well Drilling Co. Albany, Oregon

ADDITIONAL DATA:

Log _____ Water Level Measurements _____ Chemical Analysis _____ Aquifer Test _____

REMARKS: