

STATE ENGINEER  
Salem, Oregon

**LINN Well Record**  
13778

STATE WELL NO. 14/4W-17A  
COUNTY LINN  
APPLICATION NO. GR-2871

OWNER: J. I. McCord


MAILING ADDRESS: Halsey,

LOCATION OF WELL: Owner's No. \_\_\_\_\_

CITY AND STATE: Oregon

NE 1/4 NE 1/4 Sec. 17 T. 14 N. S. R. 4 W., W.M.

Bearing and distance from section or subdivision corner 462' S. and 1188' W.

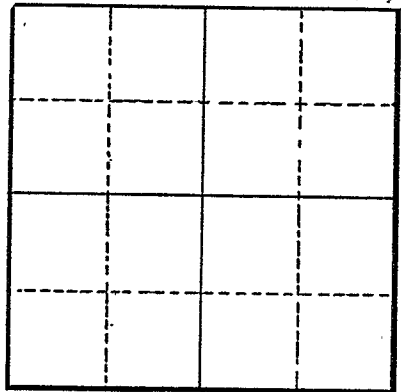

Section \_\_\_\_\_

Altitude at well \_\_\_\_\_

TYPE OF WELL: driven Date Constructed 1950

Depth drilled 27 Depth cased 27

CASING RECORD:

- 3-inch
- 4-inch

FINISH:

4-inch slot perforations from 22 to 27

AQUIFERS:

WATER LEVEL:

16-feet

PUMPING EQUIPMENT: Type Gardner Denver Centrifugal H.P. 5  
Capacity 120 G.P.M.

WELL TESTS:

Drawdown \_\_\_\_\_ ft. after \_\_\_\_\_ hours \_\_\_\_\_ G.P.M.  
Drawdown \_\_\_\_\_ ft. after \_\_\_\_\_ hours \_\_\_\_\_ G.P.M.

USE OF WATER irrigation Temp. \_\_\_\_\_ °F. \_\_\_\_\_, 19\_\_\_\_

SOURCE OF INFORMATION GR-2705

DRILLER or DIGGER Gilbert and Scott, Harrisburg, Oregon

ADDITIONAL DATA:

Log \_\_\_\_\_ Water Level Measurements \_\_\_\_\_ Chemical Analysis \_\_\_\_\_ Aquifer Test \_\_\_\_\_

REMARKS: