

STATE ENGINEER
Salem, Oregon

LINN Well Record
13779


STATE WELL NO. 14/4W-17H
COUNTY Linn
APPLICATION NO. GR-3791

OWNER: Gerald Kropf MAILING ADDRESS: Route 1,

LOCATION OF WELL: Owner's No. _____ CITY AND STATE: Halsey, Oregon

SE ¼ NE ¼ Sec. 17 T. 14 S., R. 4 W., W.M.

Bearing and distance from section or subdivision corner 1782! S. & 800! W. of NE Cor. Sec. 17

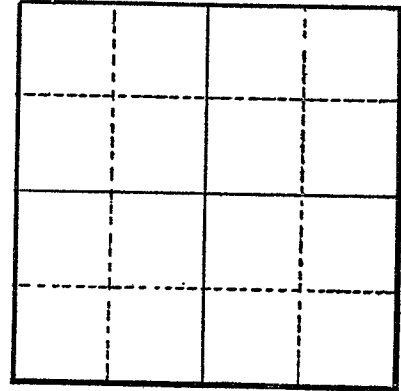

Altitude at well _____

TYPE OF WELL: Drilled Date Constructed 1954

Depth drilled 70 feet Depth cased 50 feet

CASING RECORD:

8 inch steel casing set to 50 feet

FINISH:

Slot perforations from 30 to 50 feet

AQUIFERS:

WATER LEVEL:

20 feet below surface

PUMPING EQUIPMENT: Type Fairbanks Morse turbine H.P. 5
Capacity 100 G.P.M.

WELL TESTS:

Drawdown _____ ft. after _____ hours _____ G.P.M.

Drawdown _____ ft. after _____ hours _____ G.P.M.

USE OF WATER Irrigation Temp. _____ °F., 19____

SOURCE OF INFORMATION Well Registration Statement

DRILLER or DIGGER Slate Drilling Co.

ADDITIONAL DATA:

Log _____ Water Level Measurements _____ Chemical Analysis _____ Aquifer Test _____

REMARKS: