

STATE ENGINEER  
Salem, Oregon

# Well Record

STATE WELL NO. 14/4W-17H(2)  
COUNTY Linn  
APPLICATION NO. GR-1319

**LINN**  
**13781**

GR- 1274

OWNER: Joseph Kropf

MAILING ADDRESS: 735 SW Mill St.


LOCATION OF WELL: Owner's No. \_\_\_\_\_

CITY AND STATE: Sheridan, Oregon

SE 1/4 NE 1/4 Sec. 17 T. 14 N. S., R. 4 E. W., W.M.

Bearing and distance from section or subdivision

corner 1770' S. & 200' W. from NE cor. Sec. 17.

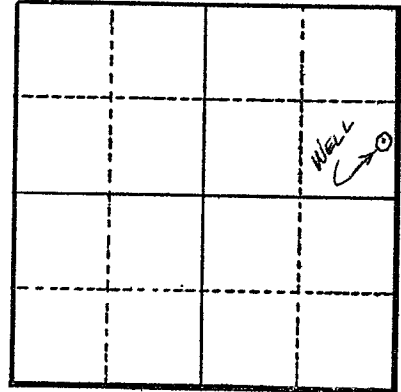

Section 17

Altitude at well 285 ft.

TYPE OF WELL: Drilled Date Constructed 1953

Depth drilled 50 ft. Depth cased 50 ft.

CASING RECORD:

8 inch

FINISH:

Perforated from 40 to 50 ft.

AQUIFERS:

WATER LEVEL:

12 ft.

PUMPING EQUIPMENT: Type F. M. turbine

H.P. 5

Capacity \_\_\_\_\_ G.P.M.

WELL TESTS:

Drawdown 30 ft. after \_\_\_\_\_ hours 65 G.P.M.

Drawdown \_\_\_\_\_ ft. after \_\_\_\_\_ hours \_\_\_\_\_ G.P.M.

USE OF WATER Irrigation

Temp. \_\_\_\_\_ °F. \_\_\_\_\_, 19

SOURCE OF INFORMATION G. R. Record

DRILLER or DIGGER Bill Howell

ADDITIONAL DATA:

Log \_\_\_\_\_ Water Level Measurements \_\_\_\_\_ Chemical Analysis \_\_\_\_\_ Aquifer Test \_\_\_\_\_

REMARKS:

Log:	Clay soil	0 to 30 ft.
	Tight gravel	30 to 38 ft.
	Sand	38 to 50 ft.
	Blue clay	50 ?????

Irrigation of 10 acres.