

STATE ENGINEER
Salem, Oregon

LINN
13786 Well Record

STATE WELL NO. 14/4W-19A(1)
COUNTY Linn
APPLICATION NO. GR-156

OWNER: E. F. Krebs

MAILING
ADDRESS: _____


LOCATION OF WELL: Owner's No. 1

CITY AND
STATE: _____

Harrisburg, Oregon

NE $\frac{1}{4}$ NE $\frac{1}{4}$ Sec. 19 T. 14 S., R. 4 W., W.M.

Bearing and distance from section or subdivision
corner S. 31° W. 3.75 chs. from NE cor. Sec. 19

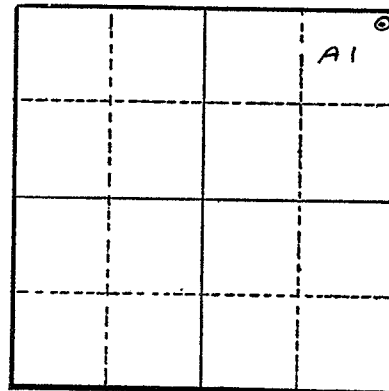

Section 19

Altitude at well 282 ft. Interpolated

TYPE OF WELL: drilled Date Constructed 4/6/53

Depth drilled 32 ft. Depth cased 32 ft.

CASING RECORD: 6 inch steel casing set from 0 to 32 ft.

FINISH: Slit perforations set from 23 to 32 ft.

AQUIFERS: Coarse gravel from 20 to 32 ft.

WATER LEVEL: 12 ft. below land surface

PUMPING EQUIPMENT: Type 3" centrifugal electric H.P. 5
Capacity 100 G.P.M.

WELL TESTS:

Drawdown 20 ft. after _____ hours pumping 137 G.P.M.

Drawdown 18 ft. after _____ hours pumping 75 G.P.M.

USE OF WATER irrigation 14.1 acres Temp. _____ °F. 19

SOURCE OF INFORMATION Reg. St. GR-156

DRILLER or DIGGER _____

ADDITIONAL DATA:

Log X Water Level Measurements _____ Chemical Analysis _____ Aquifer Test _____

REMARKS: Log: Clay 0 to 20 ft.
Gravel, coarse 20 to 32 ft.