

STATE ENGINEER
Salem, Oregon

LINN
13797

Well Record


STATE WELL NO. 14/LIN-21H
COUNTY LINN
APPLICATION NO. GR-2595

OWNER: Chris Scheffel
MAILING ADDRESS: Halsey,
CITY AND STATE: Oregon

LOCATION OF WELL: Owner's No. _____

SE 1/4 NE 1/4 Sec. 21 T. 14 S., R. 4 W., W.M.

Bearing and distance from section or subdivision
corner 2640' S. and 850' W.

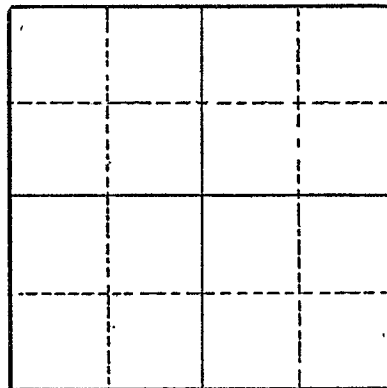

Section _____

Altitude at well _____

TYPE OF WELL: Drilled Date Constructed 1951

Depth drilled 109 Depth cased _____

CASING RECORD:

10-inch

FINISH:

1 inch by 1/4 inch about 30 per foot from 60 to 109

AQUIFERS:

Soil, gravel and clay

WATER LEVEL:

16-feet

PUMPING EQUIPMENT: Type Fairbanks Morse Centrifugal H.P. 25
Capacity 500 G.P.M.

WELL TESTS:

Drawdown 45 ft. after _____ hours Pumping 750 G.P.M.

Drawdown _____ ft. after _____ hours _____ G.P.M.

USE OF WATER Irrigation Temp. _____ °F. _____, 19.

SOURCE OF INFORMATION GR-2462

DRILLER or DIGGER _____

ADDITIONAL DATA:

Log Water Level Measurements _____ Chemical Analysis _____ Aquifer Test _____

REMARKS:

Soil 13
Water gravel to 33
Clay to 70
Water Gravel to 109 109