

STATE ENGINEER
Salem, Oregon

LINN
13807

Well Record

GR- 1658

STATE WELL NO. 14/4W-25E
COUNTY Linn
APPLICATION NO. GR- 1709

OWNER: Lee W. & Lucile C. Foster

MAILING
ADDRESS:


LOCATION OF WELL: Owner's No.

CITY AND
STATE:

Halsey, Oregon

SW 1/4 NW 1/4 Sec. 25 T. 14 S. R. 4 W., W.M.

Bearing and distance from section or subdivision
corner 14.5 ch. N.36°10'E. from SW cor. NW 1/4 Sec. 25

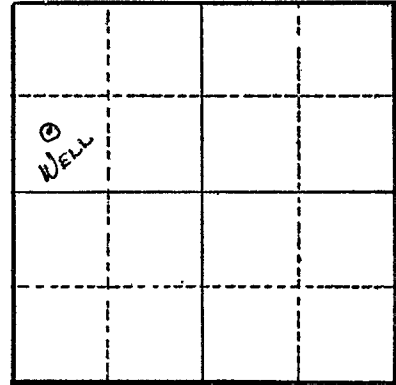

Section 25

Altitude at well 290'

TYPE OF WELL: Drilled Date Constructed 1938

Depth drilled 48' Depth cased 48'

CASING RECORD:
8"

FINISH:

Slot perforations - 2 rows from 20 to 30 ft.
5 rows from 30 to 48 ft.

AQUIFERS:

WATER LEVEL:
8'

PUMPING EQUIPMENT: Type Pacific 2" Cent. H.P. 5
Capacity 90 G.P.M.

WELL TESTS:

Drawdown 12 ft. after 90 hours G.P.M.
Drawdown ft. after hours G.P.M.

USE OF WATER Irrigation Temp. °F. 19

SOURCE OF INFORMATION GR Record

DRILLER or DIGGER

ADDITIONAL DATA:

Log Water Level Measurements Chemical Analysis Aquifer Test

REMARKS:

Log:	Clay	0 to 10 ft.
	Cement gravel	10 to 20 ft.
	Gravel (water)	20 to 22 ft.
	Cement gravel	22 to 36 ft.
	Gravel (water)	36 to 48 ft.

Irrigation of 20.5 acres.