

STATE ENGINEER  
Salem, Oregon

LINN  
13820

# Well Record

STATE WELL NO. 11/4W-29E(1)  
COUNTY Linn  
APPLICATION NO. GR-110


OWNER: Cedric and Anabel Brock  
MAILING ADDRESS: Rt. 2

LOCATION OF WELL: Owner's No. 1  
CITY AND STATE: Harrisburg, Oregon

SW 1/4 NW 1/4 Sec. 29 T. 14 N. S. R. 4 W. W.M.

Bearing and distance from section or subdivision

corner N. 75° E. 16.5 chs. from SW cor. SW 1/4 NW 1/4  
Sec. 29

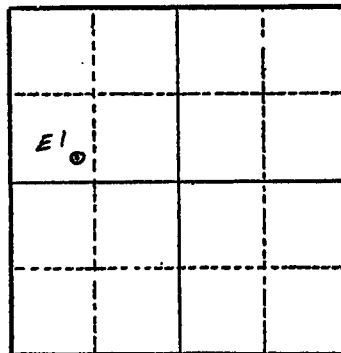

Altitude at well 285 ft. Interpolated

TYPE OF WELL: drilled Date Constructed 3/25/53

Depth drilled 52 ft. Depth cased 52 ft.

Section 29

CASING RECORD: 6 inch steel casing set from 0 to 52 ft.

FINISH: Slit perforations set from 20 to 25 ft.  
47 to 52 ft.

AQUIFERS: Sand and gravel from 28 to 52 ft.

WATER LEVEL:

PUMPING EQUIPMENT: Type Fairbanks Morse jet H.P. 3  
Capacity 55 G.P.M.

WELL TESTS:  
Drawdown 30 ft. after 55 hours G.P.M.  
Drawdown ft. after hours G.P.M.

USE OF WATER irrigation 7.7 acres Temp. °F. 19

SOURCE OF INFORMATION Reg. St. GR-110

DRILLER or DIGGER Raymond C. Cellatly; Philomath, Oregon

ADDITIONAL DATA:

Log X Water Level Measurements Chemical Analysis Aquifer Test

REMARKS:

**STATE ENGINEER**  
**Salem, Oregon**

State Well No. 14/4W-29E(1)

County Linn

Application No. GR-110

## Well Log

Owner: Cedric and Anabel Brock Owner's No. 1

Driller: Raymond C. Gellatly Date Drilled 3/25/53

[illegible]