

STATE ENGINEER
Salem, Oregon

LINN
14107

Well Record

STATE WELL NO. 15/4W-7B
COUNTY LINN
APPLICATION NO. GR-2539

OWNER: G. L. Rise

MAILING
ADDRESS:

LOCATION OF WELL: Owner's No.


CITY AND
STATE:

Harrisburg, Oregon

NW 1/4 NE 1/4 Sec. 7 T. 15 N S, R. 4 W, W.M.

Bearing and distance from section or subdivision

corner 1150' S. & 2480' W.

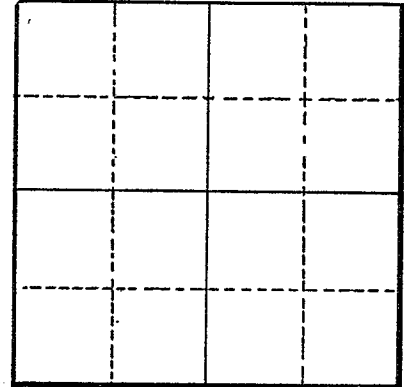

Section

Altitude at well

TYPE OF WELL: Driven Date Constructed 1949

Depth drilled 27 Depth cased 27

CASING RECORD:

5-inch

FINISH:

Standard perforations from 23 to 27

AQUIFERS:

Loam, sand & gravel

WATER LEVEL:

12-feet

PUMPING EQUIPMENT: Type Cornell Pump
Capacity 450 G.P.M.

H.P. 45

WELL TESTS:

Drawdown 2 ft. after hours Pumping 450 G.P.M.

Drawdown ft. after hours G.P.M.

USE OF WATER Irrigation Temp. °F. 19

SOURCE OF INFORMATION GR-2399

DRILLER or DIGGER

ADDITIONAL DATA:

Log Water Level Measurements Chemical Analysis Aquifer Test

REMARKS:

Loam	4'	23'
Sand & gravel	23'	0'