

STATE ENGINEER
Salem, Oregon

LINN
14123

Well Record

GR- 1612

STATE WELL NO. 15/LW-10G
COUNTY Linn
APPLICATION NO. GR- 1661

OWNER: Deryl D. Huston


MAILING ADDRESS: 1255 Diamond Hill Rd.

LOCATION OF WELL: Owner's No.

CITY AND STATE: Harrisburg, Oregon

SW 1/4 NE 1/4 Sec. 10 T. 15 S., R. 4 W., W.M.

Bearing and distance from section or subdivision corner 775' N. 34° 15' W. from SE cor. of Samuel McColley DLG #40

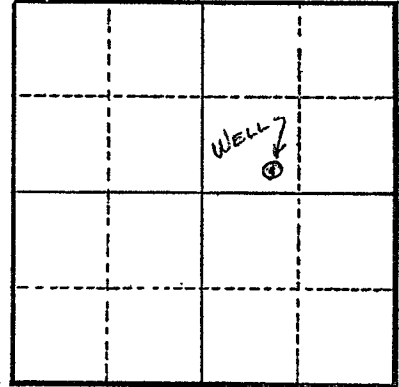

Section 10

Altitude at well 307'

TYPE OF WELL: Drilled Date Constructed 1955

Depth drilled 36' Depth cased 36'

CASING RECORD:

4"

FINISH:

Slot perforations from 30 to 36 ft.

AQUIFERS:

WATER LEVEL:

10'

PUMPING EQUIPMENT: Type A. C. 2" Cent. H.P. 3
Capacity 150 G.P.M.

WELL TESTS:

Drawdown 10 ft. after hours 75 G.P.M.

Drawdown ft. after hours G.P.M.

USE OF WATER Irrigation Temp. °F. 19

SOURCE OF INFORMATION GR Record

DRILLER or DIGGER O. B. Nye

ADDITIONAL DATA:

Log N.A. Water Level Measurements Chemical Analysis Aquifer Test

REMARKS:

Irrigation of 5 acres.