

STATE ENGINEER  
Salem, Oregon

# LINN Well Record

14124

STATE WELL NO. 15/LW-10K  
COUNTY Linn  
APPLICATION NO. GR-3454 ✓

OWNER: J. W. Miller


MAILING ADDRESS: Route 1

LOCATION OF WELL: Owner's No.

CITY AND STATE: Harrisburg, Oregon

NW 1/4 SE 1/4 Sec. 10 T. 15 N. S, R. 4 E. W., W.M.

Bearing and distance from section or subdivision corner S. 600' W. 545'

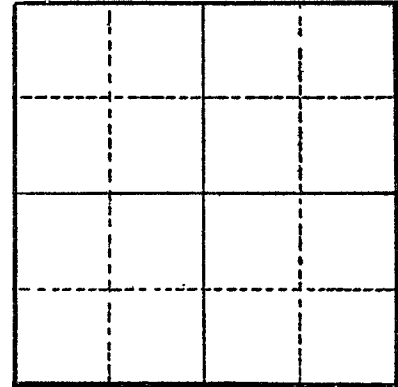

Section .....

Altitude at well

TYPE OF WELL: drilled Date Constructed 1942

Depth drilled 60' Depth cased 60'

CASING RECORD:

4"

FINISH:

1/2" x 8" slots 3 per ft. from 13 to 60

AQUIFERS:

soil, water bearing gravel and sand

WATER LEVEL:

9'

PUMPING EQUIPMENT: Type Fairbanks Morse Cent. 2" x 1 1/2" H.P. 5  
Capacity 60 plus G.P.M.

WELL TESTS:

Drawdown ft. after hours G.P.M.  
Drawdown ft. after hours G.P.M.

USE OF WATER Irrigation Temp. °F., 19

SOURCE OF INFORMATION GR-3195

DRILLER or DIGGER

ADDITIONAL DATA:

Log  Water Level Measurements Chemical Analysis Aquifer Test

REMARKS:

Soil 10  
Water bearing gravel and sand 50 60