

STATE ENGINEER  
Salem, Oregon

# LINN Well Record

14128


STATE WELL NO. 15/4W-10P  
COUNTY LINN  
APPLICATION NO. GR-2851

OWNER: C. D. Bilyeu  
MAILING ADDRESS: 700 Smith St.,

LOCATION OF WELL: Owner's No. #1  
CITY AND STATE: Harrisburg, Oregon

SE 1/4 SW 1/4 Sec. 10 T. 15 N. S. R. 4 W., W.M.

Bearing and distance from section or subdivision corner 120' N. and 2295' E.

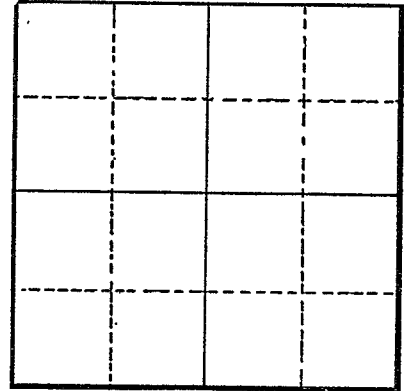

Section

Altitude at well

TYPE OF WELL: driven drilled Date Constructed 1947

Depth drilled 35 Depth cased 35

### CASING RECORD:

4-inch  
8-inch

### FINISH:

4-inch from 30 to 35  
8-inch from 25 to 35

### AQUIFERS:

### WATER LEVEL:

9-feet

PUMPING EQUIPMENT: Type Centrifugal H.P. 5  
Capacity 100 G.P.M.

### WELL TESTS:

Drawdown ft. after hours G.P.M.  
Drawdown ft. after hours G.P.M.

USE OF WATER irrigation Temp. °F. 19

SOURCE OF INFORMATION GR-2685

DRILLER or DIGGER Everett Scott, Harrisburg, Oregon; Slate Drilling Co., Tangent, Ore.

### ADDITIONAL DATA:

Log Water Level Measurements Chemical Analysis Aquifer Test

### REMARKS: