

STATE ENGINEER
Salem, Oregon

LINN
14171 Well Record

STATE WELL NO. 15/4W-150
COUNTY LINN
APPLICATION NO. GR-2852

OWNER: C. D. Bilyeu


MAILING ADDRESS: 700 Smith Street

LOCATION OF WELL: Owner's No. #2

CITY AND STATE: Harrisburg, Oregon

NE 1/4 NW 1/4 Sec. 15 T. 15 N. S., R. 4 W., W.M.

Bearing and distance from section or subdivision corner 270' S. and 3910' W.

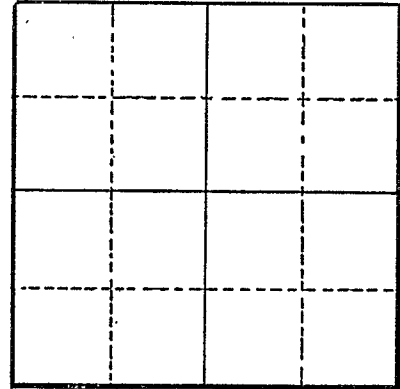

Section

Altitude at well

TYPE OF WELL: drilled Date Constructed 1948

Depth drilled 90 Depth cased 28

CASING RECORD:

10-inch

FINISH:

AQUIFERS:

WATER LEVEL:

15-feet

PUMPING EQUIPMENT: Type Deep well turbine H.P. 5
Capacity 100 G.P.M.

WELL TESTS:

Drawdown ft. after hours G.P.M.
Drawdown ft. after hours G.P.M.

USE OF WATER Temp. °F. 19

SOURCE OF INFORMATION GR-2686

DRILLER or DIGGER Slate Drilling Co., Tangent, Oregon

ADDITIONAL DATA:

Log Water Level Measurements Chemical Analysis Aquifer Test

REMARKS: