

STATE ENGINEER
Salem, Oregon

LINN Well Record
14172

STATE WELL NO. 15/LW-15C
COUNTY Linn
APPLICATION NO. GR-237

OWNER: Oscar E. Piper/ owner
Harrisburg Water System

MAILING
ADDRESS:


LOCATION OF WELL: Owner's No. 2

CITY AND
STATE:

Harrisburg, Oregon

NE 1/4 NW 1/4 Sec. 15 T. 15 N. S. R. 4 E. W., W.M.

Bearing and distance from section or subdivision
corner 1400' E. & 300' S. NW cor. Sec. 15

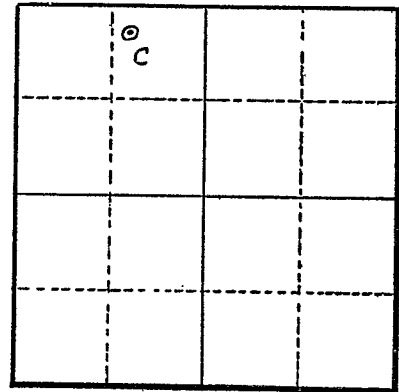

Section 15

Altitude at well 308 ft.

TYPE OF WELL: drilled Date Constructed 1947

Depth drilled 77 ft. Depth cased 55 ft.

CASING RECORD: 8 in. casing 0 to 55 ft.

FINISH:

AQUIFERS:

WATER LEVEL: 12 ft.

PUMPING EQUIPMENT: Type Deep well turbine Demming H.P. 7 1/2
Capacity 125 G.P.M.

WELL TESTS:

Drawdown 16 ft. after 60 hours G.P.M.

Drawdown ft. after hours G.P.M.

USE OF WATER municipal Temp. °F. 19

SOURCE OF INFORMATION Oscar E. Pipe/owner

DRILLER or DIGGER

ADDITIONAL DATA:

Log Water Level Measurements Chemical Analysis Aquifer Test

REMARKS: