

STATE ENGINEER
Salem, Oregon

LINN
14175

Well Record

GR- 1273

STATE WELL NO. 15/4W-15F
COUNTY Linn
APPLICATION NO. GR- 1317

OWNER: R. E. or Bessie I. Bierly

MAILING
ADDRESS:


LOCATION OF WELL: Owner's No.

CITY AND
STATE:

Harrisburg, Oregon

SE 1/4 NW 1/4 Sec. 15 T. 15 N. 4 W., W.M.

Bearing and distance from section or subdivision
corner S. 71° 10' E. 18.5 ch. from NW cor. David
McCully DIC #43

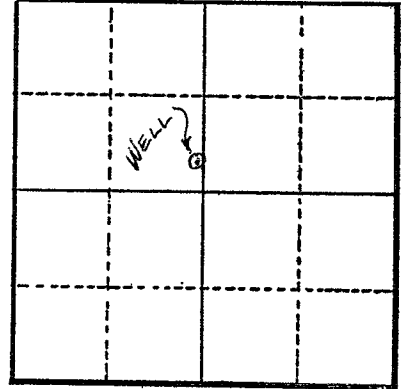

Section 15

Altitude at well 310 ft.

TYPE OF WELL: Drilled Date Constructed 1953

Depth drilled 50 ft. Depth cased 50 ft.

CASING RECORD:

6 inch

FINISH:

Perforated: Slots from 30 to 36 ft.
Slots from 44 to 50 ft.

AQUIFERS:

WATER LEVEL:

18 ft.

PUMPING EQUIPMENT: Type Jacuzzi Deep Well

H.P. 3

Capacity 100 G.P.M.

WELL TESTS:

Drawdown ft. after hours G.P.M.

Drawdown ft. after hours G.P.M.

USE OF WATER Irrigation Temp. °F. 19

SOURCE OF INFORMATION G. R. Record

DRILLER or DIGGER Mack Slate

ADDITIONAL DATA:

Log N.A. Water Level Measurements Chemical Analysis Aquifer Test

REMARKS:

Irrigation of 6 acres.