

STATE ENGINEER
Salem, Oregon

LINN
14176

Well Record

STATE WELL NO. 15/4W-15N
COUNTY Linn
APPLICATION NO. GR-3971

OWNER: J. Ira McNutt

MAILING

ADDRESS: 827 Mill St.

LOCATION OF WELL: Owner's No. _____


CITY AND

STATE: Springfield, Oregon

SW $\frac{1}{4}$ SW $\frac{1}{4}$ Sec. 15 T. 15 S., R. 4 W., W.M.

Bearing and distance from section or subdivision

corner 880' N. & 1010' E. of SW Cor. Sec. 15

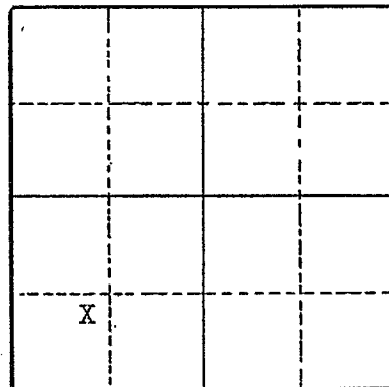

Section 15

Altitude at well _____

TYPE OF WELL: Drilled Date Constructed 1950

Depth drilled 35 ft. Depth cased _____

CASING RECORD:

FINISH:

No point in perforations, bottom 8 ft. of casing slotted 3 inches long x $\frac{1}{2}$ inch slots from 27 to 35 feet

AQUIFERS:

WATER LEVEL:

10 feet below surface

PUMPING EQUIPMENT: Type U. S. Electric Motors Pump H.P. 40

Capacity 900 G.P.M.

WELL TESTS:

Drawdown 3 ft. after _____ hours 900 G.P.M.

Drawdown _____ ft. after _____ hours _____ G.P.M.

USE OF WATER Irrigation Temp. _____ °F., 19

SOURCE OF INFORMATION Well Registration Statement Cert. # GR-3586

DRILLER or DIGGER _____

ADDITIONAL DATA:

Log Water Level Measurements _____ Chemical Analysis _____ Aquifer Test _____

REMARKS:

Log:	Thickness	Depth to Bottom
Soil and loam	6	6
Sand and gravel	251	31
Clay	4	35