

STATE ENGINEER
Salem, Oregon

LINN Well Record
14185

STATE WELL NO. 15/4W-16A(1)
COUNTY Linn A(2)
APPLICATION NO. GR-237

OWNER: Oscar E. Piper


MAILING ADDRESS: Harrisburg, Water Department

LOCATION OF WELL: Owner's No. 1 & 2

CITY AND STATE: Harrisburg, Oregon

NE $\frac{1}{4}$ NE $\frac{1}{4}$ Sec. 16 T. 15 N. S., R. 4 E. W., W.M.

Bearing and distance from section or subdivision
corner 740 ft. W. & 650 ft. S. from NE cor. Sec. 16

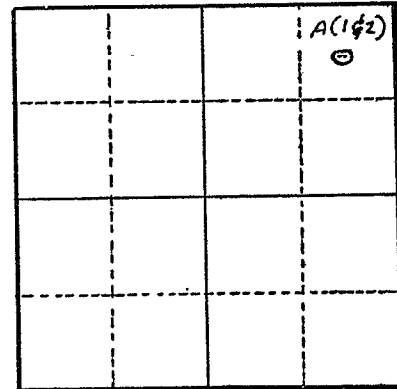

Altitude at well 308 ft. Interpolated

TYPE OF WELL dug&driven Date Constructed 1900

Depth drilled 60 ft. Depth cased _____

Section 16

CASING RECORD: Dug - 11 ft. diameter to 35 ft. 3 - 4 in. pipes driven 25 ft.

FINISH: none

AQUIFERS: unknown

WATER LEVEL: 16 ft.

PUMPING EQUIPMENT: Type Gould Triplex H.P. 10
Capacity 150 G.P.M.

WELL TESTS:
Drawdown 8 ft. after _____ hours pumping 70 G.P.M.
Drawdown _____ ft. after _____ hours _____ G.P.M.

USE OF WATER municipal Temp. _____ °F. _____, 19____
SOURCE OF INFORMATION Reg. St. GR-237

DRILLER or DIGGER _____

ADDITIONAL DATA:

Log _____ Water Level Measurements _____ Chemical Analysis _____ Aquifer Test _____

REMARKS: