

STATE ENGINEER
Salem, Oregon

LINN Well Record
14194


STATE WELL NO. 15/LW-21H
COUNTY Linn
APPLICATION NO. GR-4237

OWNER: Ronald E. McNutt MAILING ADDRESS: 351 1/2 E. Broadway

LOCATION OF WELL: Owner's No. _____ CITY AND STATE: Eugene, Oregon

Well # 3
SE 1/4 NE 1/4 Sec. 21 T. 15 S., R. 4 W., W.M.

Bearing and distance from section or subdivision corner 2150' S. & 1130' W. of NE Cor. Sec. 21

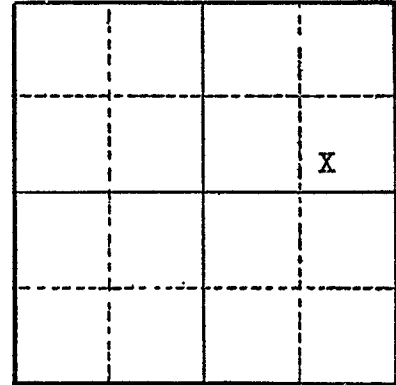

Section 21

Altitude at well _____

TYPE OF WELL: Drilled Date Constructed 1950

Depth drilled 40 ft. Depth cased 40 ft.

CASING RECORD:

FINISH:

No point, bottom 8' of casing slotted 3" long x 1/2" slots from 32 to 40 feet

AQUIFERS:

WATER LEVEL:

10 feet below surface

PUMPING EQUIPMENT: Type Pacific portable H.P. 40
Capacity 650 G.P.M.

WELL TESTS:

Drawdown 3 ft. after _____ hours 650 G.P.M.
Drawdown _____ ft. after _____ hours _____ G.P.M.

USE OF WATER Irrigation Temp. _____ °F., 19

SOURCE OF INFORMATION Well Registration Statement Cert. # GR-3777

DRILLER or DIGGER _____

ADDITIONAL DATA:

Log Water Level Measurements _____ Chemical Analysis _____ Aquifer Test _____

REMARKS:

Log:	Thickness	Depth to Bottom
Soil & loam	6	6
Sand & gravel	30	36
Clay	4	40