

STATE ENGINEER
Salem, Oregon

LINN
14205

Well Record


STATE WELL NO. 15/4W-22D
COUNTY Linn
APPLICATION NO. GR-4236

OWNER: Ronald E. McNutt
Well #2
LOCATION OF WELL: Owner's No. _____

MAILING ADDRESS: 351 1/2 E. Broadway
CITY AND STATE: Eugene, Oregon

NW 1/4 NW 1/4 Sec. 22 T. 15 S., R. 4 W., W.M.

Bearing and distance from section or subdivision
corner 205' S. & 220' E. of NW Cor. Sec. 22

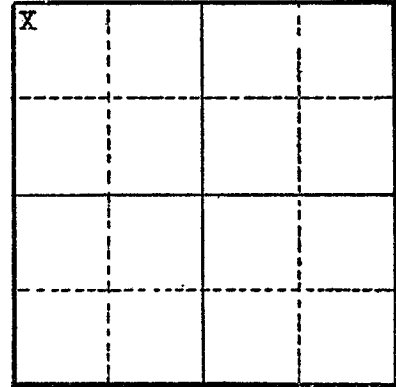

Section 22

Altitude at well _____

TYPE OF WELL: Drilled Date Constructed 1950

Depth drilled 40 ft. Depth cased 40 ft.

CASING RECORD:

FINISH:

No point, bottom 8' of casing slotted, 3" long x 1/2" slots from 32 to 40 feet

AQUIFERS:

WATER LEVEL:

10 feet below surface

PUMPING EQUIPMENT: Type Pacific portable H.P. 40
Capacity 650 G.P.M.

WELL TESTS:

Drawdown 3 ft. after _____ hours 650 G.P.M.
Drawdown _____ ft. after _____ hours _____ G.P.M.

USE OF WATER Irrigation Temp. _____ °F., 19 _____

SOURCE OF INFORMATION Well Registration Statement Cert. # GR-3776

DRILLER or DIGGER _____

ADDITIONAL DATA:

Log Water Level Measurements _____ Chemical Analysis _____ Aquifer Test _____

REMARKS:

Log:	Thickness	Depth to Bottom
Soil & loam	6	6
Sand & gravel	30	36
Clay	4	40