

STATE ENGINEER
Salem, Oregon

LINN
14206

Well Record


STATE WELL NO. 15/LW-22D
COUNTY Linn
APPLICATION NO. GR-3972

OWNER: J. Ira McNutt MAILING ADDRESS: 827 Mill St.

LOCATION OF WELL: Owner's No. _____ CITY AND STATE: Springfield, Oregon

NW 1/4 NW 1/4 Sec. 22 T. 15 S. R. 4 W., W.M.

Bearing and distance from section or subdivision
corner 900' S. & 900' E. of NW Cor. Sec. 22

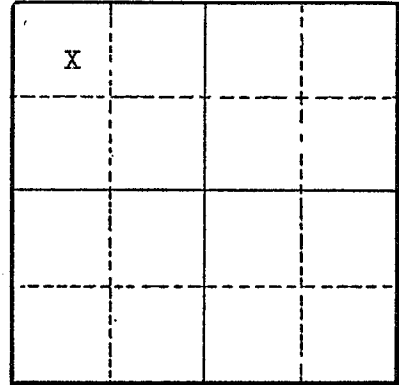

Section 22

Altitude at well _____

TYPE OF WELL: Drilled Date Constructed 1950

Depth drilled 35 ft. Depth cased _____

CASING RECORD:

FINISH:

No point in perforations, bottom 8 feet of casing slotted 3" long x 1/2" slots from 27 feet to 35 feet

AQUIFERS:

WATER LEVEL:

10 feet below surface

PUMPING EQUIPMENT: Type U. S. Electric Motors pump H.P. 40
Capacity 900 G.P.M.

WELL TESTS:

Drawdown 3 ft. after _____ hours 900 G.P.M.
Drawdown _____ ft. after _____ hours _____ G.P.M.

USE OF WATER Irrigation Temp. _____ °F. _____, 19

SOURCE OF INFORMATION Well Registration Statement Cert. # GR-3587

DRILLER or DIGGER _____

ADDITIONAL DATA:

Log X Water Level Measurements _____ Chemical Analysis _____ Aquifer Test _____

REMARKS:

Log:	Thickness	Depth to Bottom
Soil and loam	6	6
Sand and gravel	25	31
Clay	4	35