

STATE ENGINEER
Salem, Oregon

LINN
14207

Well Record

STATE WELL NO. 15/4W-22E
COUNTY Linn
APPLICATION NO. GR-3974

OWNER: J. Ira McNutt


MAILING ADDRESS: 827 Mill St.

LOCATION OF WELL: Owner's No.

CITY AND STATE: Springfield, Oregon

SW 1/4 NW 1/4 Sec. 22 T. 15 S. R. 4 W., W.M.

Bearing and distance from section or subdivision
corner 2470' S. & 820' E. of NW Cor. Sec. 22

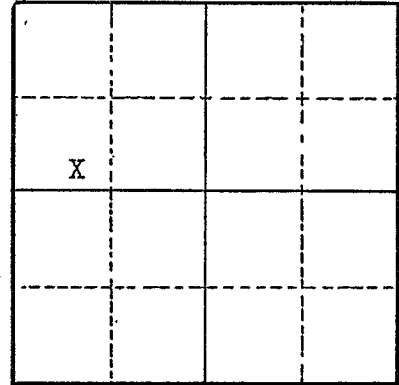

Section 22

Altitude at well

TYPE OF WELL: drilled Date Constructed 1950

Depth drilled 35 ft. Depth cased

CASING RECORD:

FINISH:

No point bottom 8 ft. of casing slotted, 3" long x 1/2" slots from 27 to 35 ft.

AQUIFERS:

WATER LEVEL:

PUMPING EQUIPMENT: Type U. S. Electric Motors Pump H.P. 40
Capacity 650 G.P.M.

WELL TESTS:

Drawdown 3 ft. after 650 hours G.P.M.

Drawdown ft. after hours G.P.M.

USE OF WATER Irrigation Temp. °F. 19

SOURCE OF INFORMATION Well Registration Statement Cert. # GR-3589

DRILLER or DIGGER

ADDITIONAL DATA:

Log X Water Level Measurements Chemical Analysis Aquifer Test

REMARKS:

Log:	Thickness	Depth to Bottom
Soil and loam	6	6
Sand and gravel	25	31
Clay	4	35