

STATE ENGINEER  
Salem, Oregon


LINN  
14208

Well Record

STATE WELL NO. 15/4W-22F  
COUNTY Linn  
APPLICATION NO. GR-3973

OWNER: J. Ira McNutt  
MAILING ADDRESS: 827 Mill St.  
CITY AND STATE: Springfield, Oregon

LOCATION OF WELL: Owner's No. \_\_\_\_\_  
SE 1/4 NW 1/4 Sec. 22 T. 15 S., R. 4 W., W.M.  
Bearing and distance from section or subdivision  
corner 1400' S. & 1880' E. of NW Cor. Sec. 22

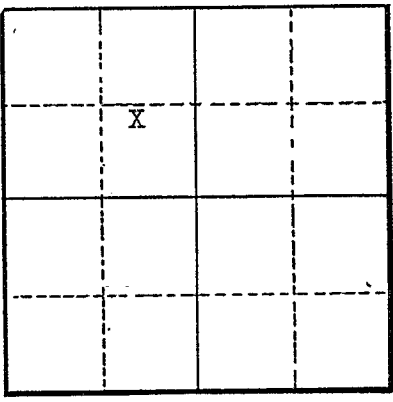

Section 22

Altitude at well \_\_\_\_\_

TYPE OF WELL: Drilled Date Constructed 1950

Depth drilled 35 ft. Depth cased \_\_\_\_\_

CASING RECORD:

FINISH:

no point bottom 8 feet of casing slotted 3" long x 1/2" slots from 27 to 35 feet

AQUIFERS:

WATER LEVEL:

10 feet below surface

PUMPING EQUIPMENT: Type U. S. Electric Motors Pump H.P. 40  
Capacity 900 G.P.M.

WELL TESTS:

Drawdown \_\_\_\_\_ ft. after \_\_\_\_\_ hours \_\_\_\_\_ G.P.M.  
Drawdown \_\_\_\_\_ ft. after \_\_\_\_\_ hours \_\_\_\_\_ G.P.M.

USE OF WATER Irrigation Temp. \_\_\_\_\_ °F., 19

SOURCE OF INFORMATION Well Registration Statement Cert. # GR-3588

DRILLER or DIGGER \_\_\_\_\_

ADDITIONAL DATA:

Log X Water Level Measurements \_\_\_\_\_ Chemical Analysis \_\_\_\_\_ Aquifer Test \_\_\_\_\_

REMARKS:

Log:	Thickness	Depth to Bottom
Soil and loam	6	6
Sand and gravel	25	31
Clay	4	35