

STATE ENGINEER
Salem, Oregon

LINN

14224

Well Record

GR- 1322

STATE WELL NO. 15/4W-26K
COUNTY Linn
APPLICATION NO. GR-1364

OWNER: P. J. Stroda


MAILING
ADDRESS: Rt. 1

LOCATION OF WELL: Owner's No. #1

CITY AND
STATE: Harrisburg, Oregon

NW $\frac{1}{4}$ SE $\frac{1}{4}$ Sec. 26 T. 15 S. R. 4 W., W.M.

Bearing and distance from section or subdivision
corner 1975' N. & 2100' W. from SE cor. Sec. 26

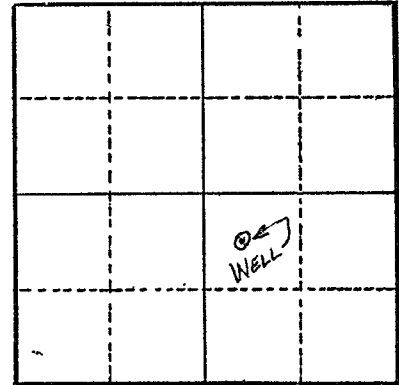

Altitude at well 310 ft.

TYPE OF WELL: Drilled Date Constructed 1949

Depth drilled 50 ft. Depth cased 50 ft.

Section 26

CASING RECORD:

6 inch

FINISH:

Slot perforated from 40 to 50 ft.

AQUIFERS:

WATER LEVEL:

12 ft.

PUMPING EQUIPMENT: Type F. M. Jet H.P. 5
Capacity 85 G.P.M.

WELL TESTS:

Drawdown _____ ft. after _____ hours _____ G.P.M.
Drawdown _____ ft. after _____ hours _____ G.P.M.

USE OF WATER Irrigation Temp. _____ °F. _____, 19_____

SOURCE OF INFORMATION G. R. Record

DRILLER or DIGGER Sloper

ADDITIONAL DATA:

Log N.A. Water Level Measurements _____ Chemical Analysis _____ Aquifer Test _____

REMARKS:

Irrigation of 3 acres.