

STATE ENGINEER
Salem, Oregon

LINN
14225


Well Record

GR- 1323

STATE WELL NO. 15/4W-26M
COUNTY Linn
APPLICATION NO. GR- 1365

OWNER: P. J. Stroda
MAILING ADDRESS: Rt. 1
CITY AND STATE: Harrisburg, Oregon

LOCATION OF WELL: Owner's No. #2
NW 1/4 SW 1/4 Sec. 26 T. 15 S., R. 4 W., W.M.
Bearing and distance from section or subdivision corner 2376' N. & 695' E. from SW cor. Sec. 26

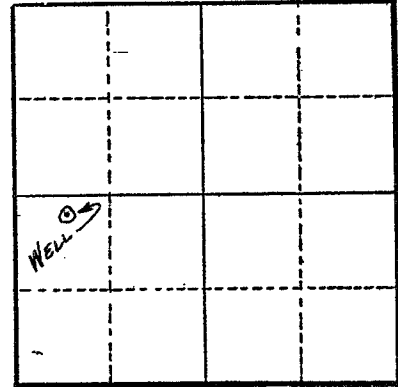

Section 26

Altitude at well 310 ft.

TYPE OF WELL: Drilled Date Constructed 1955

Depth drilled 25 ft. Depth cased 25 ft.

CASING RECORD:

5 inch

FINISH:

Slot perforations from 20 to 25 ft.

AQUIFERS:

WATER LEVEL:

12 ft.

PUMPING EQUIPMENT: Type F. M. 3 in. Cent. H.P. 28

Capacity 500 G.P.M.

WELL TESTS:

Drawdown ft. after hours G.P.M.
Drawdown ft. after hours G.P.M.

USE OF WATER Irrigation Temp. °F. 19

SOURCE OF INFORMATION G. R. Record

DRILLER or DIGGER Mort Christenson

ADDITIONAL DATA:

Log N.A. Water Level Measurements Chemical Analysis Aquifer Test

REMARKS:

Irrigation of 20 acres.