

STATE ENGINEER  
Salem, Oregon

**LINN**  
**14232**

# Well Record


STATE WELL NO. 15/4W-27H(1)  
COUNTY Linn  
APPLICATION NO. GR-701

OWNER: Otto Stroda MAILING ADDRESS: \_\_\_\_\_

LOCATION OF WELL: Owner's No. 1 CITY AND STATE: Harrisburg, Oregon

SE 1/4 NE 1/4 Sec. 27 T. 15 N. S. R. 4 W., W.M.

Bearing and distance from section or subdivision  
corner N. 57° 30' W. 15.5 chs. from SE cor. NE 1/4 Sec. 27

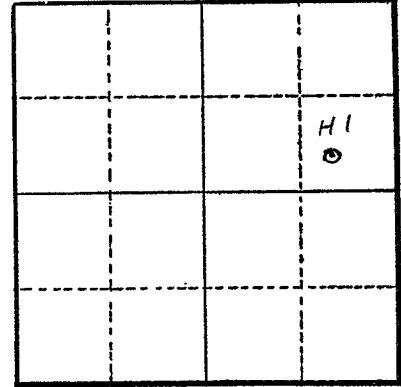

Section 27

Altitude at well 320 ft. Interpolated

TYPE OF WELL: drilled Date Constructed 5/1/53

Depth drilled 22 ft. Depth cased 22 ft.

CASING RECORD: 5 inch

FINISH:

AQUIFERS:

WATER LEVEL: 12 ft.

PUMPING EQUIPMENT: Type Berkeley centrifugal H.P. 15  
Capacity 350 G.P.M.

WELL TESTS:  
Drawdown 3 ft. after \_\_\_\_\_ hours 350 G.P.M.  
Drawdown \_\_\_\_\_ ft. after \_\_\_\_\_ hours \_\_\_\_\_ G.P.M.

USE OF WATER irrigation 24 acres Temp. \_\_\_\_\_ °F. \_\_\_\_\_, 19\_\_\_\_

SOURCE OF INFORMATION GR-701

DRILLER or DIGGER Mark Christensen; Eugene, Oregon

ADDITIONAL DATA:  
Log \_\_\_\_\_ Water Level Measurements \_\_\_\_\_ Chemical Analysis \_\_\_\_\_ Aquifer Test \_\_\_\_\_

REMARKS: