

STATE ENGINEER
Salem, Oregon

LINN
14233


Well Record

STATE WELL NO. 15/LW-27H(2)
COUNTY Linn
APPLICATION NO. GR-702

OWNER: Otto Stroda MAILING ADDRESS: _____

LOCATION OF WELL: Owner's No. 2 CITY AND STATE: Harrisburg, Oregon

SE $\frac{1}{4}$ NE $\frac{1}{4}$ Sec. 27 T. 15 S., R. 4 W., W.M.
Bearing and distance from section or subdivision
corner N. 19° 10' W. 7.75 chs. from SE cor. NE $\frac{1}{4}$ Sec. 27

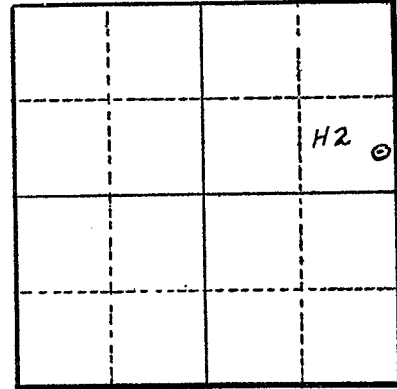

Section 27

Altitude at well 320 ft. Interpolated

TYPE OF WELL: drilled Date Constructed 5/1/53

Depth drilled 22 ft. Depth cased 22 ft.

CASING RECORD: 5 inch

FINISH:

AQUIFERS:

WATER LEVEL: 12 ft.

PUMPING EQUIPMENT: Type Berkeley centrifugal H.P. 15
Capacity 350 G.P.M.

WELL TESTS:
Drawdown 3 ft. after _____ hours 350 G.P.M.
Drawdown _____ ft. after _____ hours _____ G.P.M.

USE OF WATER irrigation 24 acres Temp. _____ °F. _____, 19____

SOURCE OF INFORMATION GR-702
DRILLER or DIGGER Mark Christensen; Eugene, Oregon

ADDITIONAL DATA:
Log _____ Water Level Measurements _____ Chemical Analysis _____ Aquifer Test _____

REMARKS: