

STATE ENGINEER
Salem, Oregon

LINN Well Record

14234

STATE WELL NO. 15/LW-27J(1)
COUNTY Linn
APPLICATION NO. GR-516

OWNER: George Stroda

MAILING ADDRESS:

LOCATION OF WELL: Owner's No. 1


CITY AND STATE:

Harrisburg, Oregon

NE 1/4 SE 1/4 Sec. 27 T. 15 S. R. 4 W., W.M.

Bearing and distance from section or subdivision

corner S. 59° 50' W. 10 chs. from NE cor. SE 1/4 Sec. 27

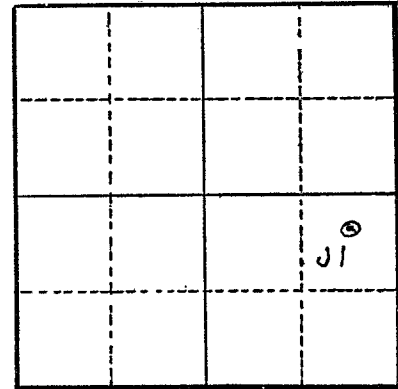

Section 27

Altitude at well 320 ft.

TYPE OF WELL: drilled Date Constructed 1/15/52

Depth drilled 20 ft. Depth cased 20 ft.

CASING RECORD: 4 inch

FINISH:

AQUIFERS:

WATER LEVEL: 10 ft.

PUMPING EQUIPMENT: Type Berkeley centrifugal H.P. 10
Capacity 250 G.P.M.

WELL TESTS:
Drawdown ft. after hours G.P.M.
Drawdown ft. after hours G.P.M.

USE OF WATER irrigation 17.2 acres Temp. °F., 19

SOURCE OF INFORMATION GR-516

DRILLER or DIGGER owner

ADDITIONAL DATA:

Log Water Level Measurements Chemical Analysis Aquifer Test

REMARKS: