

STATE ENGINEER  
Salem, Oregon

**LINN** Well Record  
14235

STATE WELL NO. 15/LW-27J(2)  
COUNTY Linn  
APPLICATION NO. GR-517

OWNER: George Strada

MAILING  
ADDRESS:


LOCATION OF WELL: Owner's No. 2

CITY AND  
STATE:

Harrisburg, Oregon

NE  $\frac{1}{4}$  SE  $\frac{1}{4}$  Sec. 27 T. 15 N. S, R. 4 E. W., W.M.

Bearing and distance from section or subdivision  
corner S. 29° W. 17 chs. from NE cor. SE  $\frac{1}{4}$  Sec. 27

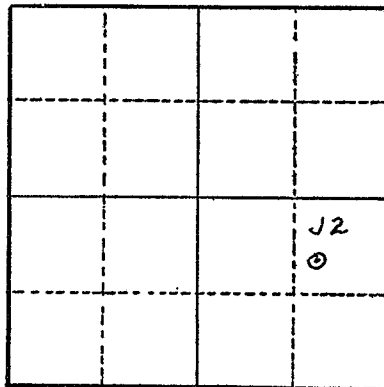

Section 27

Altitude at well 320 ft.

TYPE OF WELL: drilled Date Constructed 3/15/53

Depth drilled 20 ft. Depth cased 20 ft.

CASING RECORD: 5 inch

FINISH:

AQUIFERS:

WATER LEVEL: 10 ft.

PUMPING EQUIPMENT: Type Berkeley centrifugal H.P. 10  
Capacity 250 G.P.M.

WELL TESTS:

Drawdown \_\_\_\_\_; ft. after \_\_\_\_\_ hours 500 G.P.M.

Drawdown \_\_\_\_\_ ft. after \_\_\_\_\_ hours \_\_\_\_\_ G.P.M.

USE OF WATER irrigation 7.2 acres Temp. \_\_\_\_\_ °F. \_\_\_\_\_, 19

SOURCE OF INFORMATION GR0517

DRILLER or DIGGER owner

ADDITIONAL DATA:

Log \_\_\_\_\_ Water Level Measurements \_\_\_\_\_ Chemical Analysis \_\_\_\_\_ Aquifer Test \_\_\_\_\_

REMARKS: