

STATE ENGINEER
Salem, Oregon

LINN
14236

Well Record


STATE WELL NO. 15/LW-27J(3)
COUNTY Linn
APPLICATION NO. GR-518

OWNER: George Stroda
MAILING ADDRESS:

LOCATION OF WELL: Owner's No. 3
CITY AND STATE: Harrisburg, Oregon

NE 1/4 SE 1/4 Sec. 27 T. 15 S., R. 4 W., W.M.

Bearing and distance from section or subdivision
corner S. 29° W. 17 chs. from NE cor. SE 1/4 Sec. 27

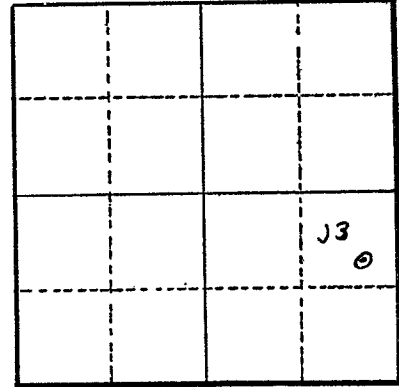

Section 27

Altitude at well 320 ft.

TYPE OF WELL: drilled Date Constructed 2/10/48

Depth drilled 20 ft. Depth cased 20 ft.

CASING RECORD: 2 1/2 inch

FINISH:

AQUIFERS:

WATER LEVEL: 100 ft.

PUMPING EQUIPMENT: Type Berkeley centrifugal H.P. 5
Capacity 100 G.P.M.

WELL TESTS:
Drawdown 3 ft. after 100 hours G.P.M.
Drawdown ft. after hours G.P.M.

USE OF WATER irrigation 7.2 acres Temp. °F. 19

SOURCE OF INFORMATION GR-518

DRILLER or DIGGER owner

ADDITIONAL DATA:
Log Water Level Measurements Chemical Analysis Aquifer Test

REMARKS: