

STATE ENGINEER
Salem, Oregon

LINN
14240

Well Record

GR- 1575

STATE WELL NO. 15/LW-34R
COUNTY Linn
APPLICATION NO. GR- 1617

OWNER: Bryan & Mildred Smith


MAILING ADDRESS: Rt. 1

LOCATION OF WELL: Owner's No. #1

CITY AND STATE: Harrisburg, Oregon

SE 1/4 SE 1/4 Sec. 34 T. 15 S., R. 4 W., W.M.

Bearing and distance from section or subdivision corner N. 35° 20' W. 12 ch. from SE cor. Sec. 34

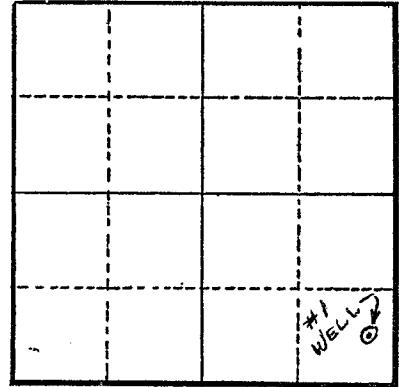

Section 34

Altitude at well 325'

TYPE OF WELL: Dug Date Constructed 1940

Depth drilled 14' Depth cased 14'

CASING RECORD:

4" x 4" cased with lumber

FINISH:

AQUIFERS:

WATER LEVEL:

7'

PUMPING EQUIPMENT: Type Berkeley 3" Cent. H.P. 20

Capacity 600 G.P.M.

WELL TESTS:

Drawdown 3 ft. after 600 G.P.M.

Drawdown ft. after hours G.P.M.

USE OF WATER Irrigation Temp. °F. 19

SOURCE OF INFORMATION GR Record

DRILLER or DIGGER Owner

ADDITIONAL DATA:

Log Water Level Measurements Chemical Analysis Aquifer Test

REMARKS:

Log: Top soil 0 to 6 ft.
 Clay 6 to 7 ft.
 Gravel 7 to 9 ft.
 Gravel & sand 9 to 14 ft.

Irrigation of 53 acres.