

STATE ENGINEER
Salem, Oregon

LINN
14353

Well Record

STATE WELL NO. 16/LW-1D(1)
COUNTY Linn
APPLICATION NO. GR-80

OWNER: Vernon H. and Lena Woods


MAILING ADDRESS: 5130 River Road South

LOCATION OF WELL: Owner's No. 1

CITY AND STATE: Harrisburg, Oregon

NW 1/4 NW 1/4 Sec. 1 T. 16 N. S. R. 4 E. W., W.M.

Bearing and distance from section or subdivision corner S. 8° 23' E. 16.11 chs. from NW cor. Sec. 1

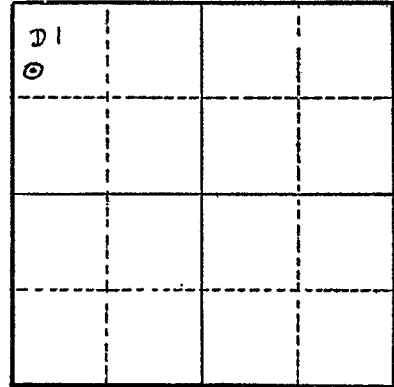

Section 1

Altitude at well 335 ft. Interpolated

TYPE OF WELL: driven Date Constructed 4/10/50

Depth drilled 21 ft. Depth cased 21 ft.

CASING RECORD: 2 inch driven well pipe to 21 ft.

FINISH: 3 ft. well point

AQUIFERS: Sand and gravel 12 to 21 ft.

WATER LEVEL: 10 ft. below land surface 7/10/54

PUMPING EQUIPMENT: Type 1 1/2" Berkeley centrifugal H.P. 2
Capacity 60 G.P.M.

WELL TESTS:
Drawdown 16 ft. after _____ hours 80 G.P.M.
Drawdown _____ ft. after _____ hours _____ G.P.M.

USE OF WATER irrigation 5.7 acres Temp. _____ °F. 19

SOURCE OF INFORMATION Reg. St. GR-80

DRILLER or DIGGER _____

ADDITIONAL DATA:

Log Water Level Measurements _____ Chemical Analysis _____ Aquifer Test _____

REMARKS: See map in G-205

