

STATE ENGINEER
Salem, Oregon

LINN
14355

Well Record

STATE WELL NO. 16/LW-1M(1)
COUNTY Linn
APPLICATION NO. GR-78

OWNER: Mark B. and Laura A. Smith

MAILING
ADDRESS:


LOCATION OF WELL: Owner's No. 1

CITY AND
STATE:

Harrisburg, Oregon

NW 1/4 SW 1/4 Sec. 1 T. 16 N. S. R. 1 W. W.M.

Bearing and distance from section or subdivision
corner N. 5° 10' E. 21.5 chs. from SW cor. Sec. 1

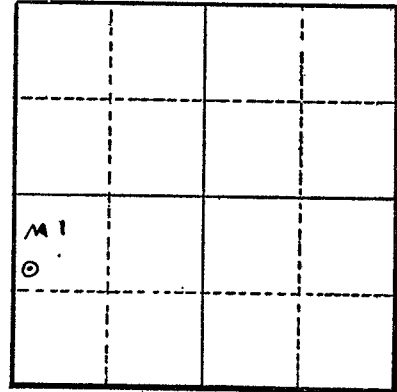

Section 1

Altitude at well 335 ft. Interpolated

TYPE OF WELL: driven Date Constructed 12/3/49

Depth drilled 25 ft. Depth cased 25 ft.

CASING RECORD: 4 inch driven well from 0 to 25 ft.

FINISH: 4" x 1/4" slits 2" apart vertically and horizontally from 21 to 25 ft.

AQUIFERS: Sand and gravel from 13 to 25 ft.

WATER LEVEL: 10 ft. below land surface 5/10/50

PUMPING EQUIPMENT: Type 3 " Pacific centrifugal H.P. 10
Capacity 320 G.P.M.

WELL TESTS:
Drawdown 14 ft. after _____ hours 400 G.P.M.
Drawdown _____ ft. after _____ hours _____ G.P.M.

USE OF WATER irrigation 25 acres Temp. _____ °F. 19

SOURCE OF INFORMATION Reg. State. GR-78

DRILLER or DIGGER _____

ADDITIONAL DATA:
Log Water Level Measurements _____ Chemical Analysis _____ Aquifer Test _____

REMARKS:

