

STATE ENGINEER
Salem, Oregon

LINN
14362

Well Record

STATE WELL NO. 16/4W-2C
COUNTY Linn
APPLICATION NO. GR-1345

GR- 1301

OWNER: H.L. Ross


MAILING ADDRESS: Rt. 1

LOCATION OF WELL: Owner's No. _____

CITY AND STATE: Harrisburg, Oregon

NE 1/4 NW 1/4 Sec. 2 T. 16 S., R. 4 W., W.M.

Bearing and distance from section or subdivision corner 5440' N30°15'W. from SE cor. Sec. 2.

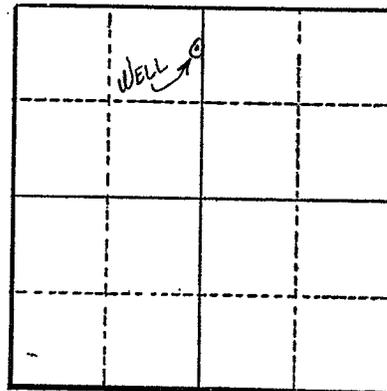

Section 2

Altitude at well _____

TYPE OF WELL: Driven Date Constructed 1941

Depth drilled 20 ft. Depth cased 20 ft.

CASING RECORD:

4 - 2 in. pipes

FINISH:

Perforated with $\frac{1}{4}$ in. round slots as close as possible from 17 to 20 ft.

AQUIFERS:

Sand & gravel

WATER LEVEL:

10 ft.

PUMPING EQUIPMENT: Type 3 in. Cent.

H.P. 10

Capacity 200 G.P.M.

WELL TESTS:

Drawdown 5 ft. after _____ hours 200 G.P.M.

Drawdown _____ ft. after _____ hours _____ G.P.M.

USE OF WATER Irrigation Temp. _____ °F. _____, 19____

SOURCE OF INFORMATION G. R. Record

DRILLER or DIGGER _____

ADDITIONAL DATA:

Log N.A. Water Level Measurements _____ Chemical Analysis _____ Aquifer Test _____

REMARKS:

Irrigation of 7 acres.