

STATE ENGINEER  
Salem, Oregon

LINN  
14363

# Well Record

STATE WELL NO. 16/4W-2H(1)  
COUNTY Linn  
APPLICATION NO. GR-80

OWNER: Vernon H. & Lena Woods


MAILING ADDRESS: 5130 River Road South

LOCATION OF WELL: Owner's No. 2

CITY AND STATE: Harrisburg, Oregon

SE 1/4 NE 1/4 Sec. 2 T. 16 S., R. 1 W., W.M.

Bearing and distance from section or subdivision  
corner S. 7° 52' W. 25.95 chs. from NE cor. Sec. 2

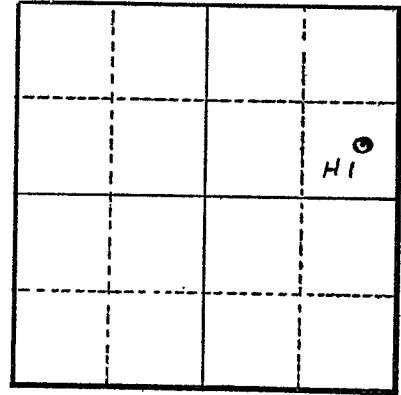

Section 2

Altitude at well 335 ft. Interpolated

TYPE OF WELL: driven Date Constructed 4/10/46

Depth drilled 26 ft. Depth cased 26 ft.

CASING RECORD: 4 inch casing set from 0 to 26 ft.

FINISH: Slits 1/4" x 1/4" on 2" spacing horizontal and vertical from 22 to 26 ft.

AQUIFERS: Sand and gravel from 16 to 26 ft.

WATER LEVEL: 10 ft. below land surface 5/3/53

PUMPING EQUIPMENT: Type 2 1/2" Berkeley centrifugal H.P. 15  
Capacity 340 G.P.M.

WELL TESTS:  
Drawdown 17 ft. after \_\_\_\_\_ hours 100 G.P.M.  
Drawdown \_\_\_\_\_ ft. after \_\_\_\_\_ hours \_\_\_\_\_ G.P.M.

USE OF WATER irrigation 30 acres Temp. \_\_\_\_\_ °F. 19

SOURCE OF INFORMATION Reg. St. GR-80

DRILLER or DIGGER \_\_\_\_\_

ADDITIONAL DATA:

Log  Water Level Measurements \_\_\_\_\_ Chemical Analysis \_\_\_\_\_ Aquifer Test \_\_\_\_\_

REMARKS: Permit 15426 .9 ac. NE 1/4 NE 1/4, 17.5 acres SW 1/4 NE 1/4, and 10.0 acres SE 1/4 NE 1/4 Sec. 2

