

STATE ENGINEER
Salem, Oregon

LINN
14364

Well Record

GR- 1592

STATE WELL NO. 16/4W-2N
COUNTY Linn
APPLICATION NO. GR- 1628

OWNER: Gerald W. & Marie Detering

MAILING
ADDRESS:


LOCATION OF WELL: Owner's No. #2

CITY AND
STATE:

Harrisburg, Oregon

SW 1/4 SW 1/4 Sec. 2 T. 16 N. S, R. 4 W., W.M.

Bearing and distance from section or subdivision
corner 528' N. & 1155' E. from SW cor. Sec. 2

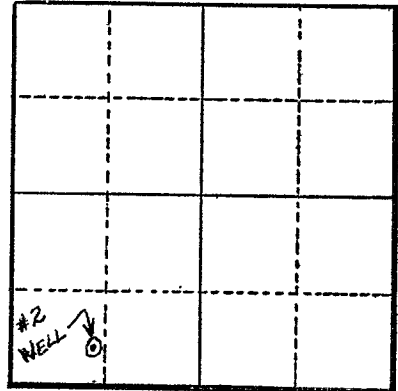

Section 2

Altitude at well 340'

TYPE OF WELL: Driven Date Constructed 1940

Depth drilled 30' Depth cased 30'

CASING RECORD:

5" - 2 connected wells

FINISH:

Slot perforations from 26 to 30 ft.

AQUIFERS:

WATER LEVEL:

12'

PUMPING EQUIPMENT: Type Berkeley 3" Cent.

H.P. 20

Capacity 500 G.P.M.

WELL TESTS:

Drawdown _____ ft. after _____ hours _____ G.P.M.

Drawdown _____ ft. after _____ hours _____ G.P.M.

USE OF WATER Irrigation Temp. _____ °F. _____, 19

SOURCE OF INFORMATION GR Record

DRILLER or DIGGER Walter V. Nelson

ADDITIONAL DATA:

Log N.A. Water Level Measurements _____ Chemical Analysis _____ Aquifer Test _____

REMARKS:

Irrigation of 54 acres.