

STATE ENGINEER
Salem, Oregon

LINN
14366

Well Record

STATE WELL NO. 16/LW-3H(1)
COUNTY Linn
APPLICATION NO. GR-537

OWNER: Ralph & Wallace Detering

MAILING
ADDRESS:


LOCATION OF WELL: Owner's No. 1

CITY AND
STATE:

Harrisburg, Oregon

SE $\frac{1}{4}$ NE $\frac{1}{4}$ Sec. 3 T. 16 N. S., R. 4 W. W.M.

Bearing and distance from section or subdivision
corner N. 39° 24' W. 66.27 chs. from SW cor. DLG 56

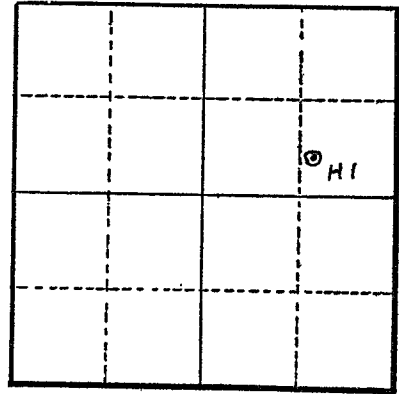

Altitude at well 335 ft.

TYPE OF WELL: driven Date Constructed May 1942

Depth drilled 20 ft. Depth cased 20 ft.

Section 3

CASING RECORD: 3 in. & 4 in. casings about 2 ft. apart.

FINISH:

AQUIFERS:

WATER LEVEL: 10 ft.

PUMPING EQUIPMENT: Type centrifugal H.P. 20
Capacity 450 G.P.M.

WELL TESTS:
Drawdown 3 ft. after _____ hours 400 G.P.M.
Drawdown _____ ft. after _____ hours _____ G.P.M.

USE OF WATER irrigation 27.8 acres Temp. _____ °F. _____, 19____

SOURCE OF INFORMATION GR-537

DRILLER or DIGGER Nelson; Junction City, Oregon

ADDITIONAL DATA:

Log _____ Water Level Measurements _____ Chemical Analysis _____ Aquifer Test _____

REMARKS: