

STATE ENGINEER
Salem, Oregon

WINN
14367

Well Record
G-5746
GR-1576

STATE WELL NO. 16/4W-3J
COUNTY Linn
APPLICATION NO. GR-1618

OWNER: Bryan & Mildred Smith


MAILING ADDRESS: Rt. 1

LOCATION OF WELL: Owner's No. #2

CITY AND STATE: Harrisburg, Oregon

NE 1/4 SE 1/4 Sec. 3 T. 16 S., R. 4 W., W.M.

Bearing and distance from section or subdivision corner S.13°10'W. 43 ch. from NE cor. Sec. 3.

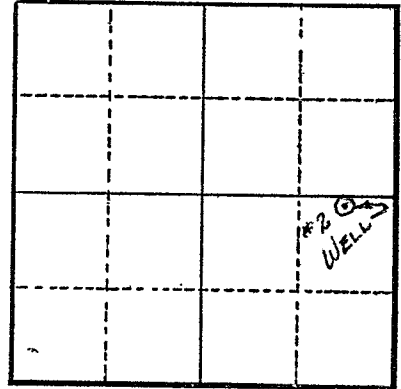

Section 3

Altitude at well 330'

TYPE OF WELL: Driven Date Constructed 1950

Depth drilled 25' Depth cased 25'

CASING RECORD:

5"

FINISH:

Slot perforations from 21 to 25 ft.

AQUIFERS:

WATER LEVEL:

13'

PUMPING EQUIPMENT: Type Berkeley 3" Cent. H.P. 20
Capacity 600 G.P.M.

WELL TESTS:

Drawdown 8 ft. after 480 hours G.P.M.

Drawdown _____ ft. after _____ hours G.P.M.

USE OF WATER Irrigation Temp. _____ °F. _____, 19

SOURCE OF INFORMATION GR Record

DRILLER or DIGGER Everett Scott

ADDITIONAL DATA:

Log N.A. Water Level Measurements _____ Chemical Analysis _____ Aquifer Test _____

REMARKS:

Irrigation of 19.3 acres.