

STATE ENGINEER  
Salem, Oregon

**LINN**  
**14369**

# Well Record

GR- 1591

STATE WELL NO. 16/4W-12N  
COUNTY Linn  
APPLICATION NO. GR- 1627

OWNER: Gerald W. & Marie Detering

MAILING  
ADDRESS:


LOCATION OF WELL: Owner's No. #3

CITY AND  
STATE:

Harrisburg, Oregon

SW 1/4 SW 1/4 Sec. 12 T. 16 S., R. 4 W., W.M.

Bearing and distance from section or subdivision  
corner 2046' S. & 660' E. from W 1/4 cor. Sec. 12

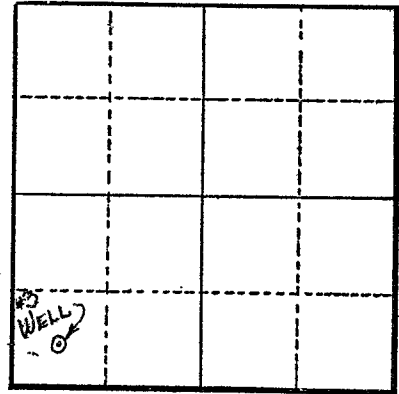

Section 12

Altitude at well 340'

TYPE OF WELL: Driven Date Constructed 1940

Depth drilled 25' Depth cased 25'

CASING RECORD:

2 - 4"

FINISH:

Slot perforations from 21 to 25 ft.

AQUIFERS:

WATER LEVEL:

12'

PUMPING EQUIPMENT: Type Berkeley 3" Cent. H.P. 20  
Capacity 500 G.P.M.

WELL TESTS:

Drawdown \_\_\_\_\_ ft. after \_\_\_\_\_ hours \_\_\_\_\_ G.P.M.

Drawdown \_\_\_\_\_ ft. after \_\_\_\_\_ hours \_\_\_\_\_ G.P.M.

USE OF WATER Irrigation Temp. \_\_\_\_\_ °F. \_\_\_\_\_, 19\_\_\_\_

SOURCE OF INFORMATION GR Record

DRILLER or DIGGER Walter V. Nelson

ADDITIONAL DATA:

Log N.A. Water Level Measurements \_\_\_\_\_ Chemical Analysis \_\_\_\_\_ Aquifer Test \_\_\_\_\_

REMARKS:

Irrigation of 17.5 acres.