

STATE ENGINEER  
Salem, Oregon

**LINN Well Record**  
14370 GR- 1143

STATE WELL NO. 16/4W-15K(1)  
COUNTY Linn  
APPLICATION NO. GR- 1182

OWNER: Floyd M. LaBar

MAILING ADDRESS: Rt. 1


LOCATION OF WELL: Owner's No. \_\_\_\_\_

CITY AND STATE: Harrisburg, Oregon

NW 1/4 SE 1/4 Sec. 15 T. 16 S., R. 4 W., W.M.

Bearing and distance from section or subdivision

corner 1390' W. & 100' S. from E<sup>1</sup> cor. of Sec. 15.

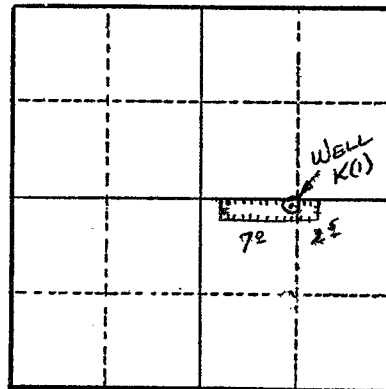

Section 15

Altitude at well 340 ft.

TYPE OF WELL: Driven Date Constructed 1953

Depth drilled 30 ft. Depth cased 30 ft.

CASING RECORD:

2 - 2 in. pipes

FINISH:

18 inches - with many fine perforations from 18 to 30 ft.

AQUIFERS:

WATER LEVEL:

8 ft.

PUMPING EQUIPMENT: Type Pacific 1 1/4 x 1 in. H.P. 3

Capacity 50 G.P.M.

WELL TESTS:

Drawdown \_\_\_\_\_ ft. after \_\_\_\_\_ hours \_\_\_\_\_ G.P.M.

Drawdown \_\_\_\_\_ ft. after \_\_\_\_\_ hours \_\_\_\_\_ G.P.M.

USE OF WATER Irrigation Temp. \_\_\_\_\_ °F., 19 \_\_\_\_\_

SOURCE OF INFORMATION G. R. Record

DRILLER or DIGGER \_\_\_\_\_

ADDITIONAL DATA:

Log N.A. Water Level Measurements \_\_\_\_\_ Chemical Analysis \_\_\_\_\_ Aquifer Test \_\_\_\_\_

REMARKS:

Irrigation of 9.5 acres.