

STATE ENGINEER  
Salem, Oregon

~~14564~~  
~~14564~~

# Linn Well Record

14564 GR- 1593

STATE WELL NO. 15/W-350  
COUNTY Linn  
APPLICATION NO. GR-1629

OWNER: Gerald W. & Marie Detering


MAILING ADDRESS:

LOCATION OF WELL: Owner's No. #1

CITY AND STATE: Harrisburg, Oregon

SW 1/4 SE 1/4 Sec. 35 T. 15 N. S. R. 4 W., W.M.

Bearing and distance from section or subdivision corner 660' S. & 580' E. from NW cor. of SW 1/4 of SE 1/4 of Sec. 35.

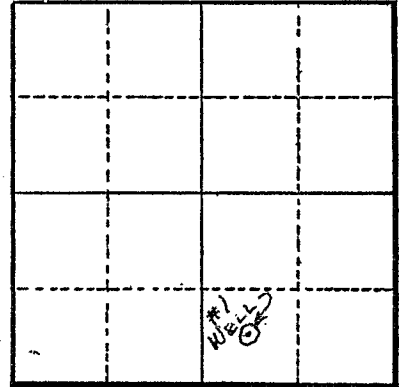

Section 35

Altitude at well 340'

TYPE OF WELL: Driven Date Constructed 1945

Depth drilled 30' Depth cased 30'

### CASING RECORD:

2 - 5" pipes connected

### FINISH:

Slot perforations from 26 to 30 ft.

### AQUIFERS:

### WATER LEVEL:

12'

PUMPING EQUIPMENT: Type Berkeley 3" Cent. H.P. 20  
Capacity 500 G.P.M.

### WELL TESTS:

Drawdown ft. after hours G.P.M.  
Drawdown ft. after hours G.P.M.

USE OF WATER Irrigation Temp. °F., 19

SOURCE OF INFORMATION GR Record

DRILLER or DIGGER Walter V. Nelson

### ADDITIONAL DATA:

Log N. A. Water Level Measurements Chemical Analysis Aquifer Test

### REMARKS:

Irrigation of 57.6 acres.