

STATE ENGINEER
Salem, Oregon

Well Record

STATE WELL NO. 12/2W-23P
COUNTY LINN
APPLICATION NO. GR-2776

OWNER: John T. and Eleanore Hermans

MAILING
ADDRESS:

575 Crowfoot St.,

LOCATION OF WELL: Owner's No.


CITY AND
STATE:

Lebanon, Oregon

SE 1/4 SW 1/4 Sec. 23 T. 12 N. S., R. 2 E. W., W.M.

Bearing and distance from section or subdivision

corner 495' N. and 2574' E.

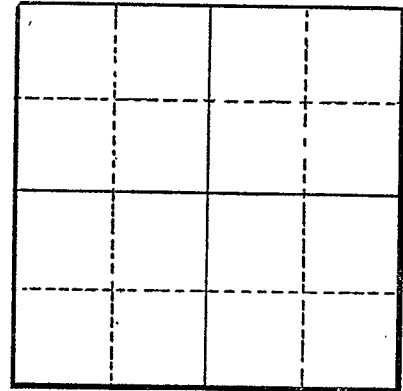

Section

Altitude at well

TYPE OF WELL: drilled Date Constructed 1950

Depth drilled 70 Depth cased 70

CASING RECORD:

8-inch

FINISH:

Slot perforations from 60 to 70

AQUIFERS:

WATER LEVEL:

20-feet

PUMPING EQUIPMENT: Type Peerless
Capacity 100 G.P.M.

H.P. 5

WELL TESTS:

Drawdown 10 ft. after hours Pumping 100 G.P.M.

Drawdown ft. after hours G.P.M.

USE OF WATER irrigation Temp. °F. 19

SOURCE OF INFORMATION GR-2623

DRILLER or DIGGER

ADDITIONAL DATA:

Log Water Level Measurements Chemical Analysis Aquifer Test

REMARKS: