

STATE ENGINEER  
Salem, Oregon

LINN  
74673

# Well Record


STATE WELL NO. 12/2W-24D(1)  
COUNTY Linn  
APPLICATION NO. GR-314

OWNER: Andy & Annabelle Hetzendorf MAILING ADDRESS: Rt. 1, Box 35

LOCATION OF WELL: Owner's No. 1 CITY AND STATE: Lebanon, Oregon

NW 1/4 NW 1/4 Sec. 24 T. 12 S., R. 2 W., W.M.

Bearing and distance from section or subdivision corner S. 46° 15' E. 1309.1 ft. from NW cor. Sec. 24

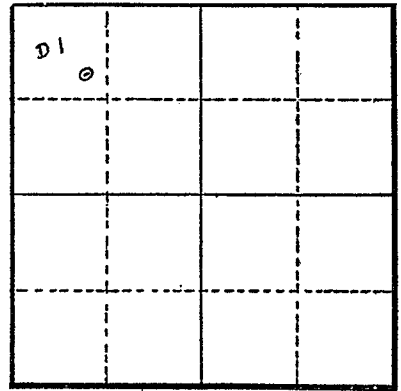

Section 24

Altitude at well 360 ft. Interpolated

TYPE OF WELL: drilled Date Constructed 5/20/51

Depth drilled 19 ft. Depth cased 19 ft.

CASING RECORD: 10 inch casing set from 0 to 19 ft.

FINISH: Dynamited

AQUIFERS: unknown

WATER LEVEL: 8 ft. below land surface

PUMPING EQUIPMENT: Type \_\_\_\_\_ H.P. \_\_\_\_\_  
Capacity \_\_\_\_\_ G.P.M.

WELL TESTS:  
Drawdown 4 ft. after \_\_\_\_\_ hours pumping 150 G.P.M.  
Drawdown \_\_\_\_\_ ft. after \_\_\_\_\_ hours \_\_\_\_\_ G.P.M.

USE OF WATER irrigation 10.8 acres Temp. \_\_\_\_\_ °F. \_\_\_\_\_, 19  
SOURCE OF INFORMATION Reg. St. GR-314

DRILLER or DIGGER \_\_\_\_\_  
ADDITIONAL DATA:

Log \_\_\_\_\_ Water Level Measurements \_\_\_\_\_ Chemical Analysis \_\_\_\_\_ Aquifer Test \_\_\_\_\_

REMARKS: